

Noel S. Musial, A.I.A.  
 CT. 09009 PA. B 6580

The Drawings, Specifications and other documents prepared by the Architect for this project are instruments of the Architect's service for use solely with respect to this project and the Architect shall be deemed the author of statutory and other reserved rights, including copyright. The owner shall be permitted to reprint copies, including reproducible copies, of the Architect's drawings. Specifications or other documents shall not be used by the Owner or others on other projects, for additions to this Project or for completion of this Project by others, unless the Architect agrees in writing and with separate compensation to the Architect.

Submission or distribution of documents to meet official regulatory requirements or for similar purposes in connection with the Project is not to be construed as publication in derogation of the Architect's reserved rights.

These drawings may not be reproduced by any means without the express written consent of the architect.

EACH CONTRACTOR SHALL THOROUGHLY EXAMINE AND BECOME FAMILIAR WITH ALL CONTRACT OCCASIONS FOR THE PROJECT AND NOT LIMIT THEIR WORK TO DRAWINGS REFERENCED FOR INDIVIDUAL TRADES.

© Copyright 2016  
 BUSINESS PROPRIETARY INFORMATION



**LESSNER FIRST FLOOR ADDITION & FIRST FLOOR & LOWER LEVEL REHABILITATION**  
 Lessner Building  
 Elizabeth Campus  
 12 West Jersey Street  
 Elizabeth, NJ 07202

**THE MUSIAL GROUP ARCHITECTURE**  
 191 Mill Lane  
 Mountainside, NJ 07092  
 t. 908.232.2860  
 f. 908.232.2845  
 e. studio@themusialgroup.com

March 2016

Revision Number	Revision Description	Revision Date
△	ADDENDUM # 1	04/05/2016
△	ADDENDUM # 2	04/11/2016
△	REVISIONS	10/31/2016

Scale:  
 Drawn by: AJS  
 Checked by: JAK

**108813**  
 Demolition  
 Plumbing  
 Low Roof Plan


**PD103**

**NOTE FOR ALL DRAWINGS:**  
 NOT ALL AREAS MAY HAVE BEEN ACCESSIBLE DURING SURVEY. ARRANGEMENT, LOCATION, AND EXTEND OF MECHANICAL, PLUMBING, AND FIRE SUPPRESSION SPRINKLER SYSTEMS SHOWN ARE TO THE BEST OF THE SURVEYOR'S ABILITY DUE TO BUILDING (SITE) CONSTRAINTS. REFERENCED DRAWINGS AVAILABLE FROM THE OWNER SHOULD BE USED BY CONTRACTOR TO ASSIST HIM/HER IN THE FIELD VERIFICATION. CONTRACTOR IS RESPONSIBLE FOR FINAL SURVEY OF ALL AREAS TO PROVIDE MECHANICAL, PLUMBING, AND FIRE SUPPRESSION SPRINKLER SYSTEMS PART OF THE DESIGN.

**PLUMBING DEMOLITION LEGEND:**

- REMOVE EXISTING PIPING
- REMOVE EXISTING EQUIPMENT
- EXISTING EQUIPMENT / PIPING TO REMAIN

**SPRINKLER SYSTEM NOTE:**  
 REFER TO EXISTING "AS BUILT" DRAWINGS BY "AMERICAN AUTOMATIC SPRINKLER CORP", DATED APR. 20, 1992.  
 VERIFY IN FIELD LOCATION OF ALL SPRINKLER PIPE MAINS AND BRANCHES.  
 TRIM OR EXTEND BRANCH SPRINKLER LINES THAT CONNECT TO NEW OR RELOCATED SPRINKLER PIPES AS NEEDED.

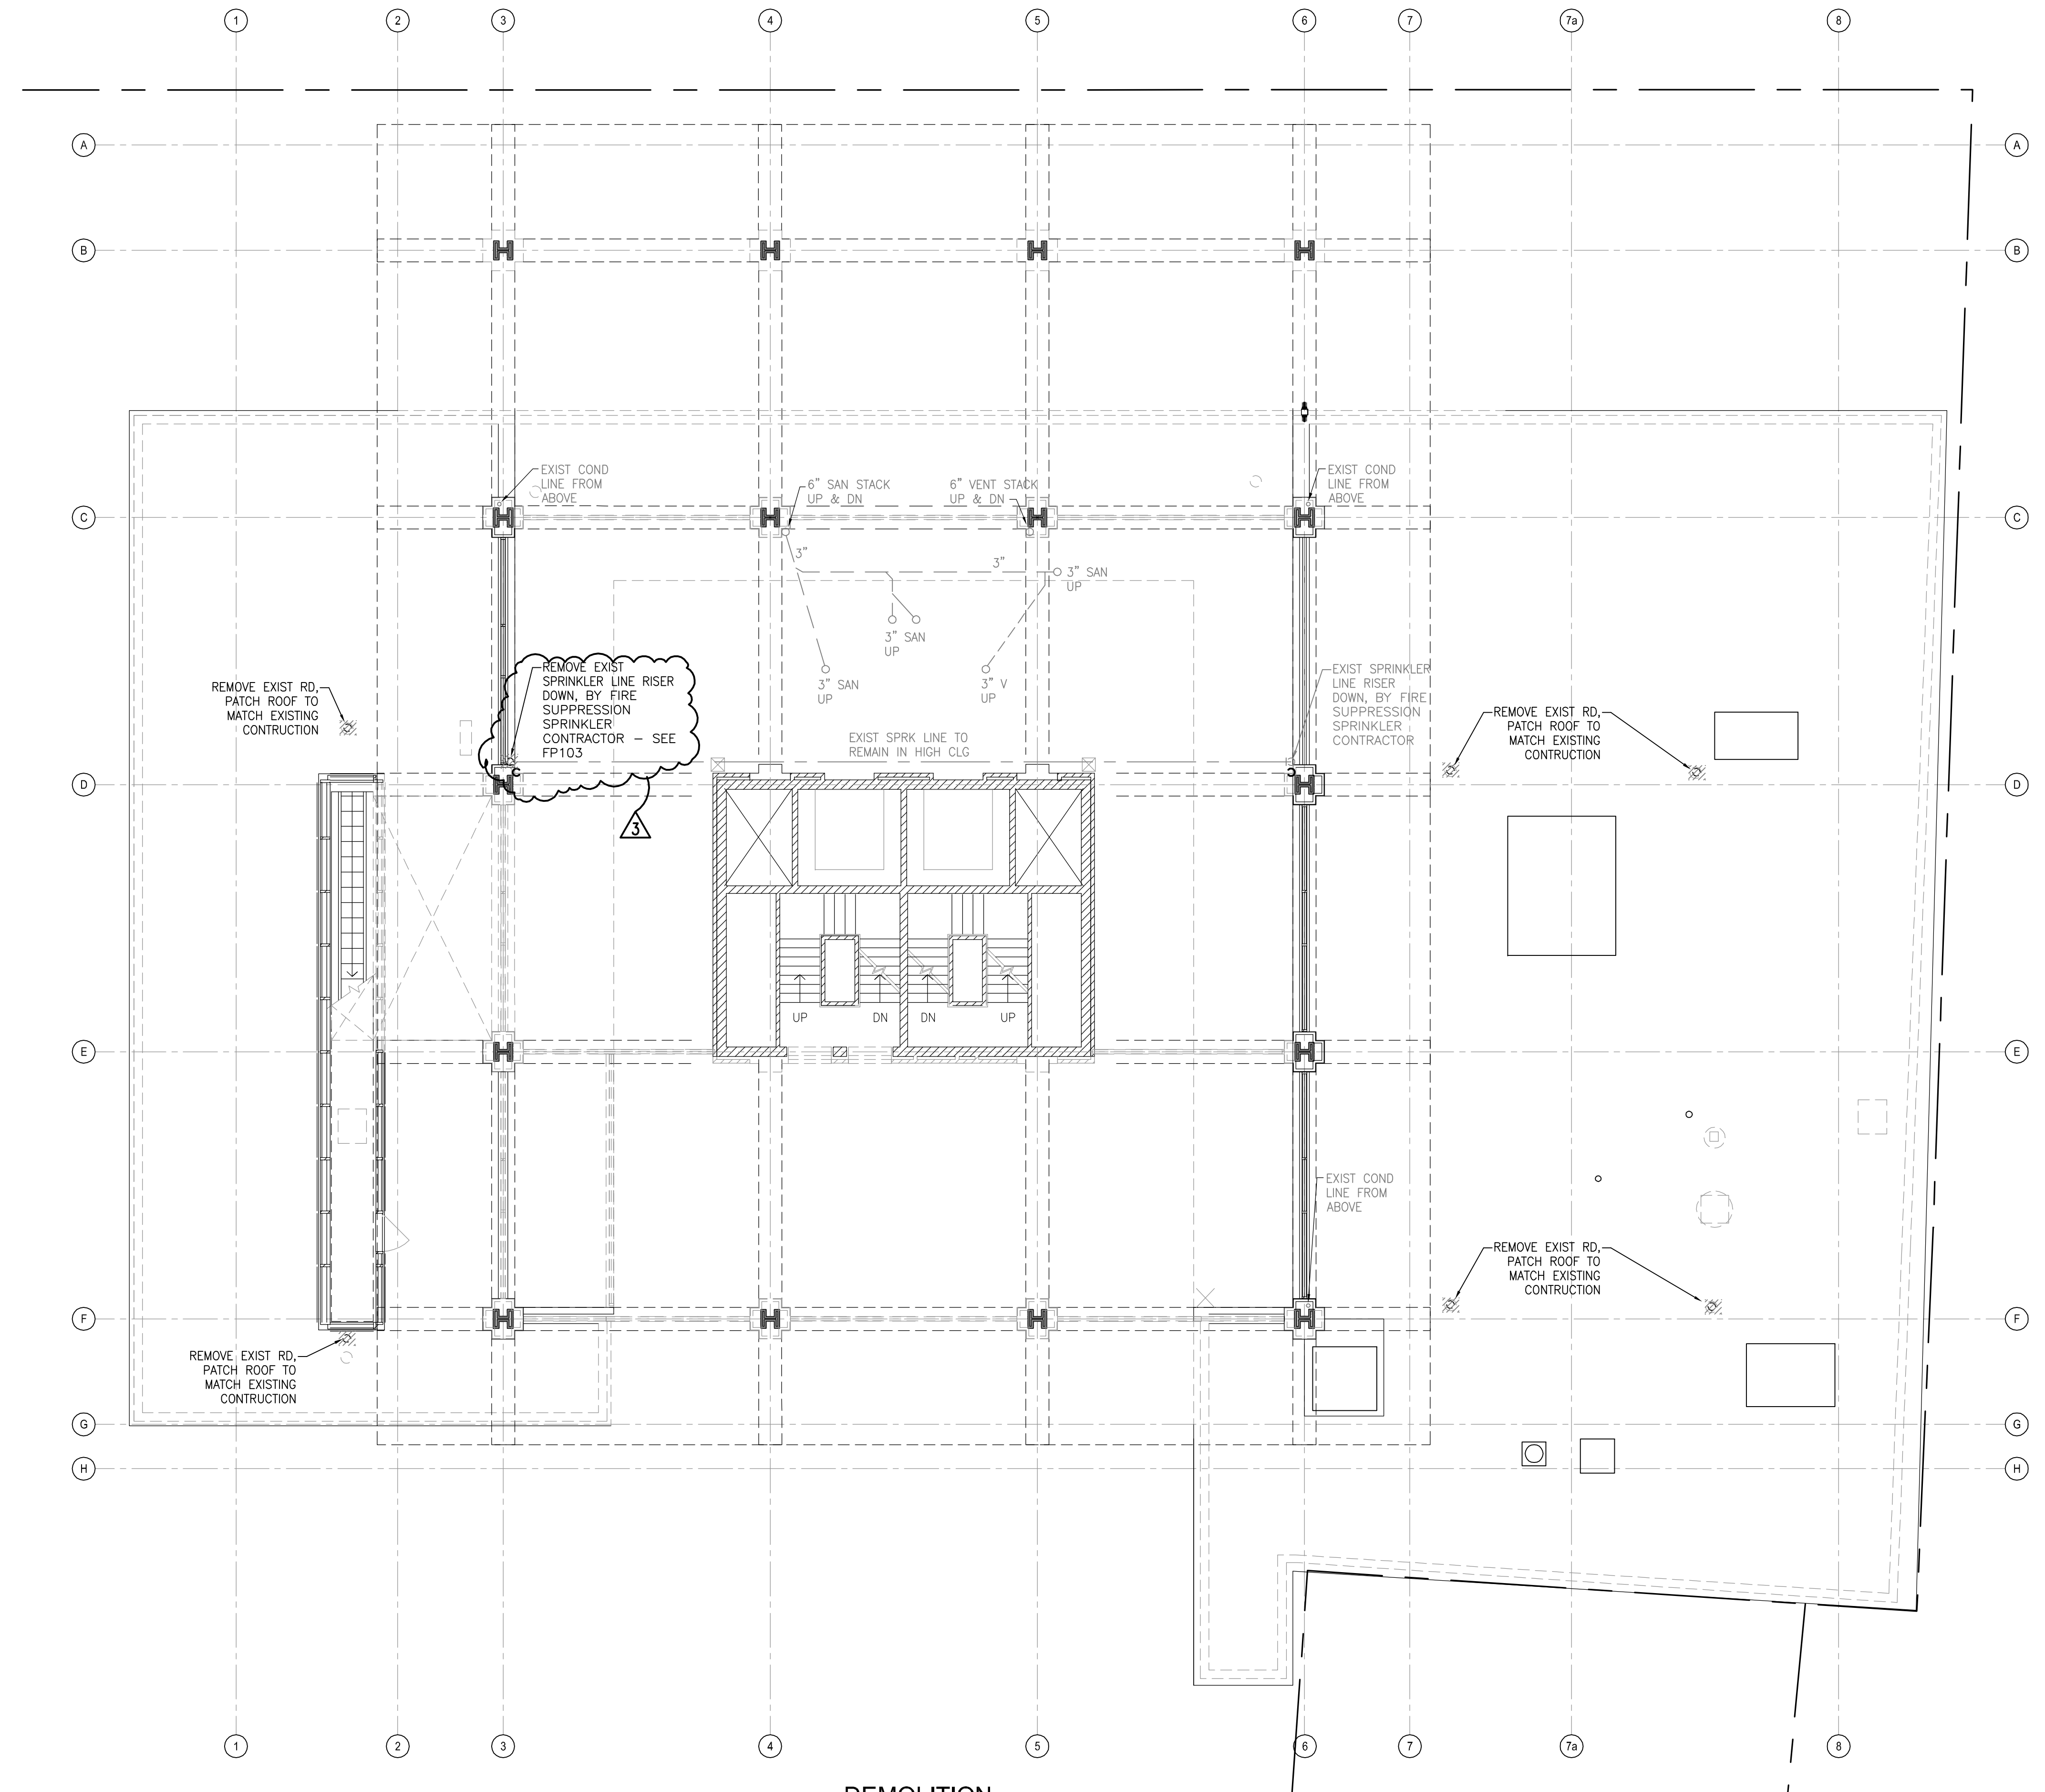

**DEMOLITION LOW ROOF PLAN**  
 SCALE: 1/8" = 1'-0"



ORIGINAL  
 IF IT IS RED IT IS AN ORIGINAL

P:\1000-1099\108813\108813 UC College 1st Fl Lessner Building - 108813.dwg, 10/31/2016 02:28:08 PM