

JERSEY MECHANICAL CONTRACTORS

5006 INDUSTRIAL ROAD
FARMINGDALE, NJ 07727
JERSEYMECHANICALCONTRACTORS.COM
732-751-9595

PROJECT:

TWO RIVER THEATER

FLOOR:

1

ADDRESS:

21 BRIDGE AVE


RED BANK, NJ

OWNER:

TWO RIVER THEATER COMPANY


ROOM:

HALL BUILDING

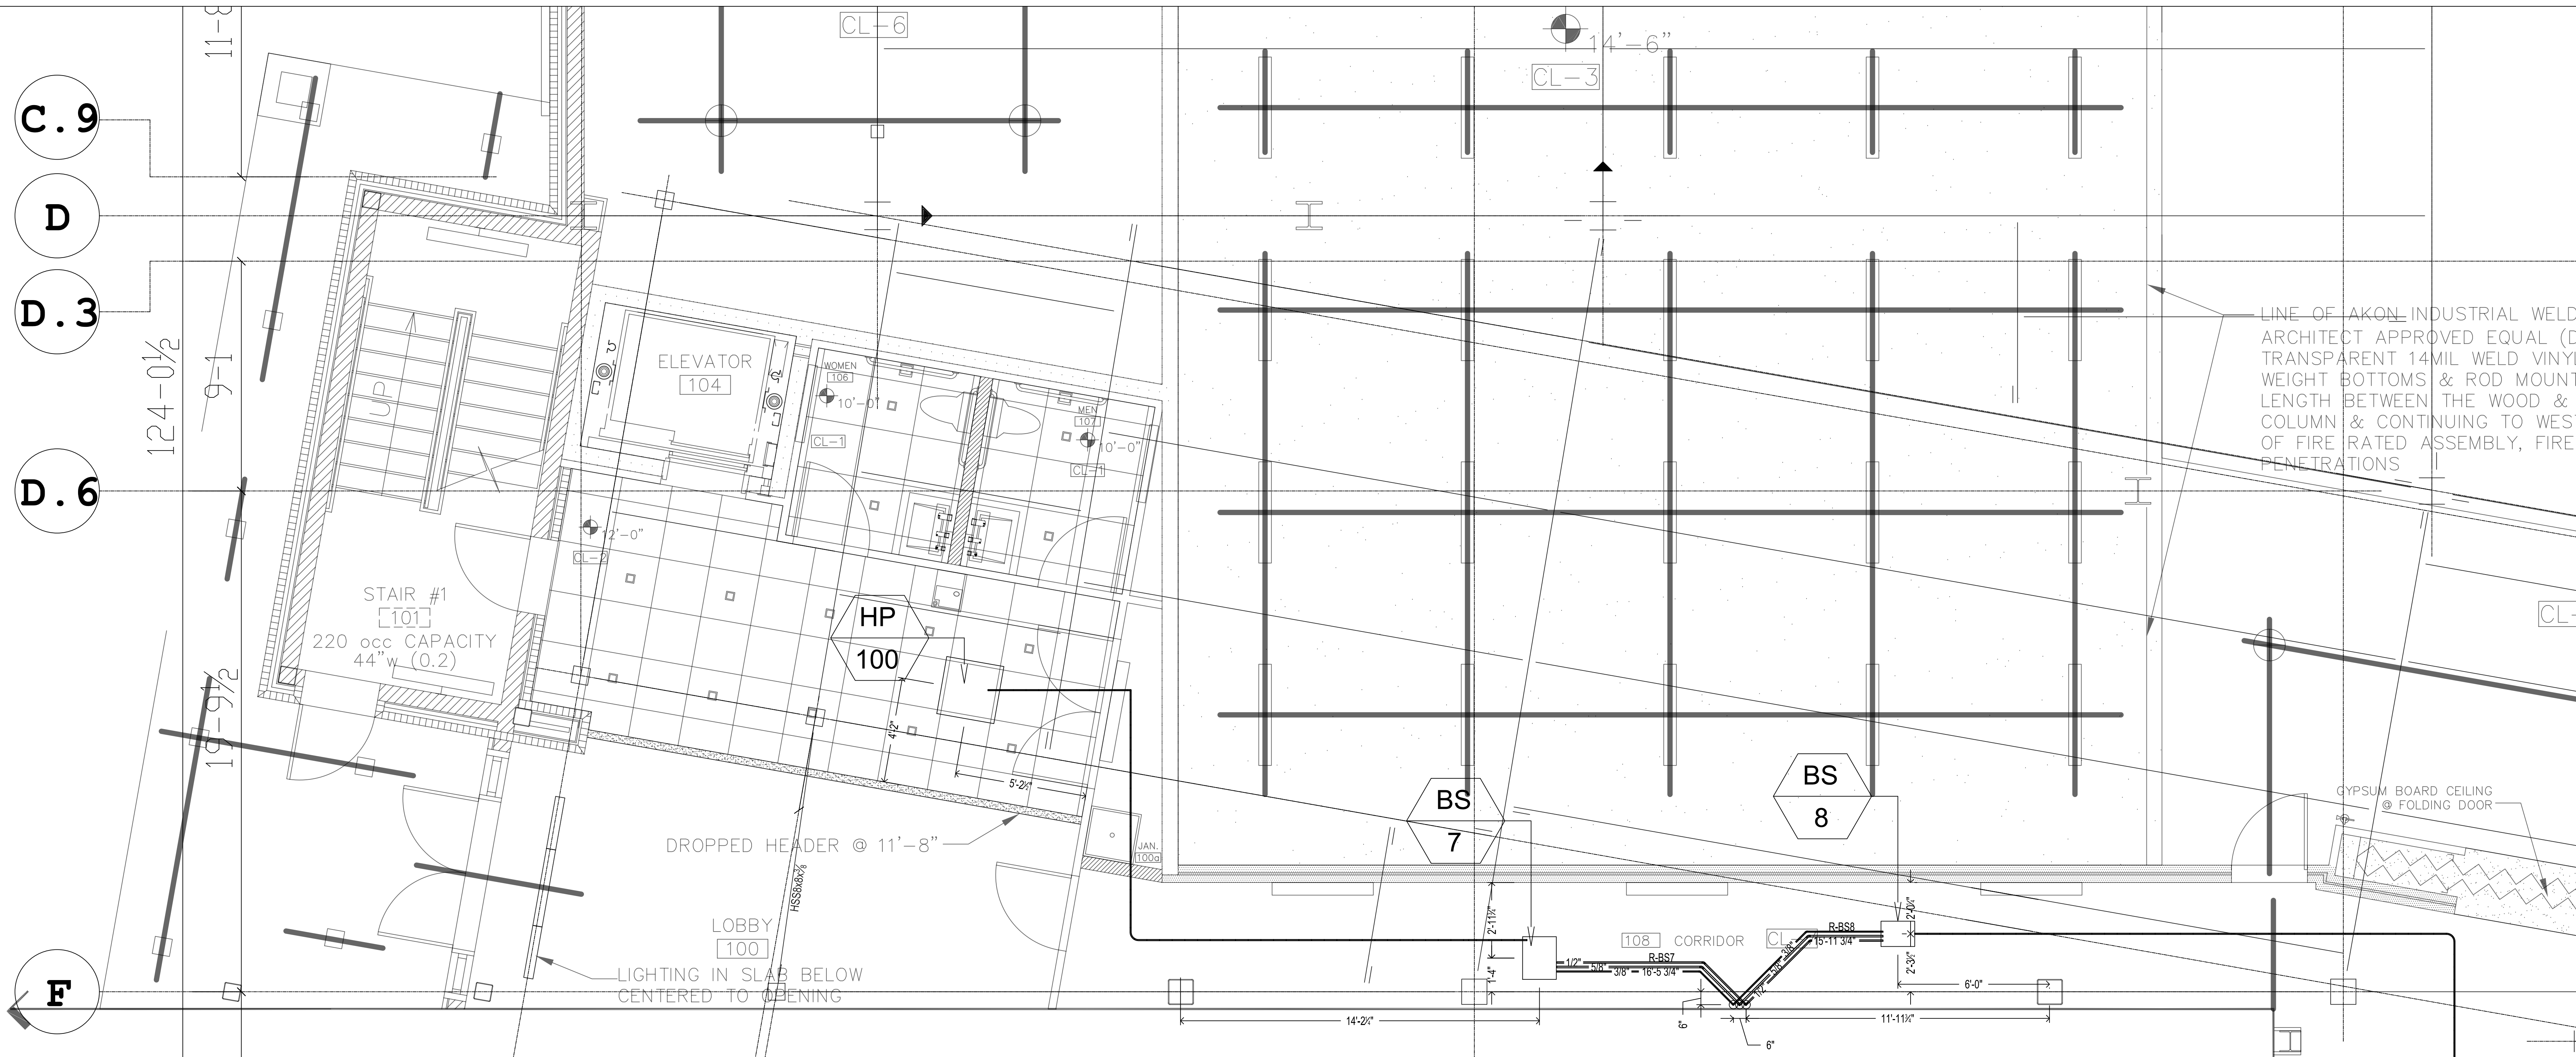

1 FIRST FLOOR REFLECTED CEILING PLAN
SCALE: 1/8" = 1'-0"

1 FIRST FLOOR PLAN
SCALE: 1/8" = 1'-0"

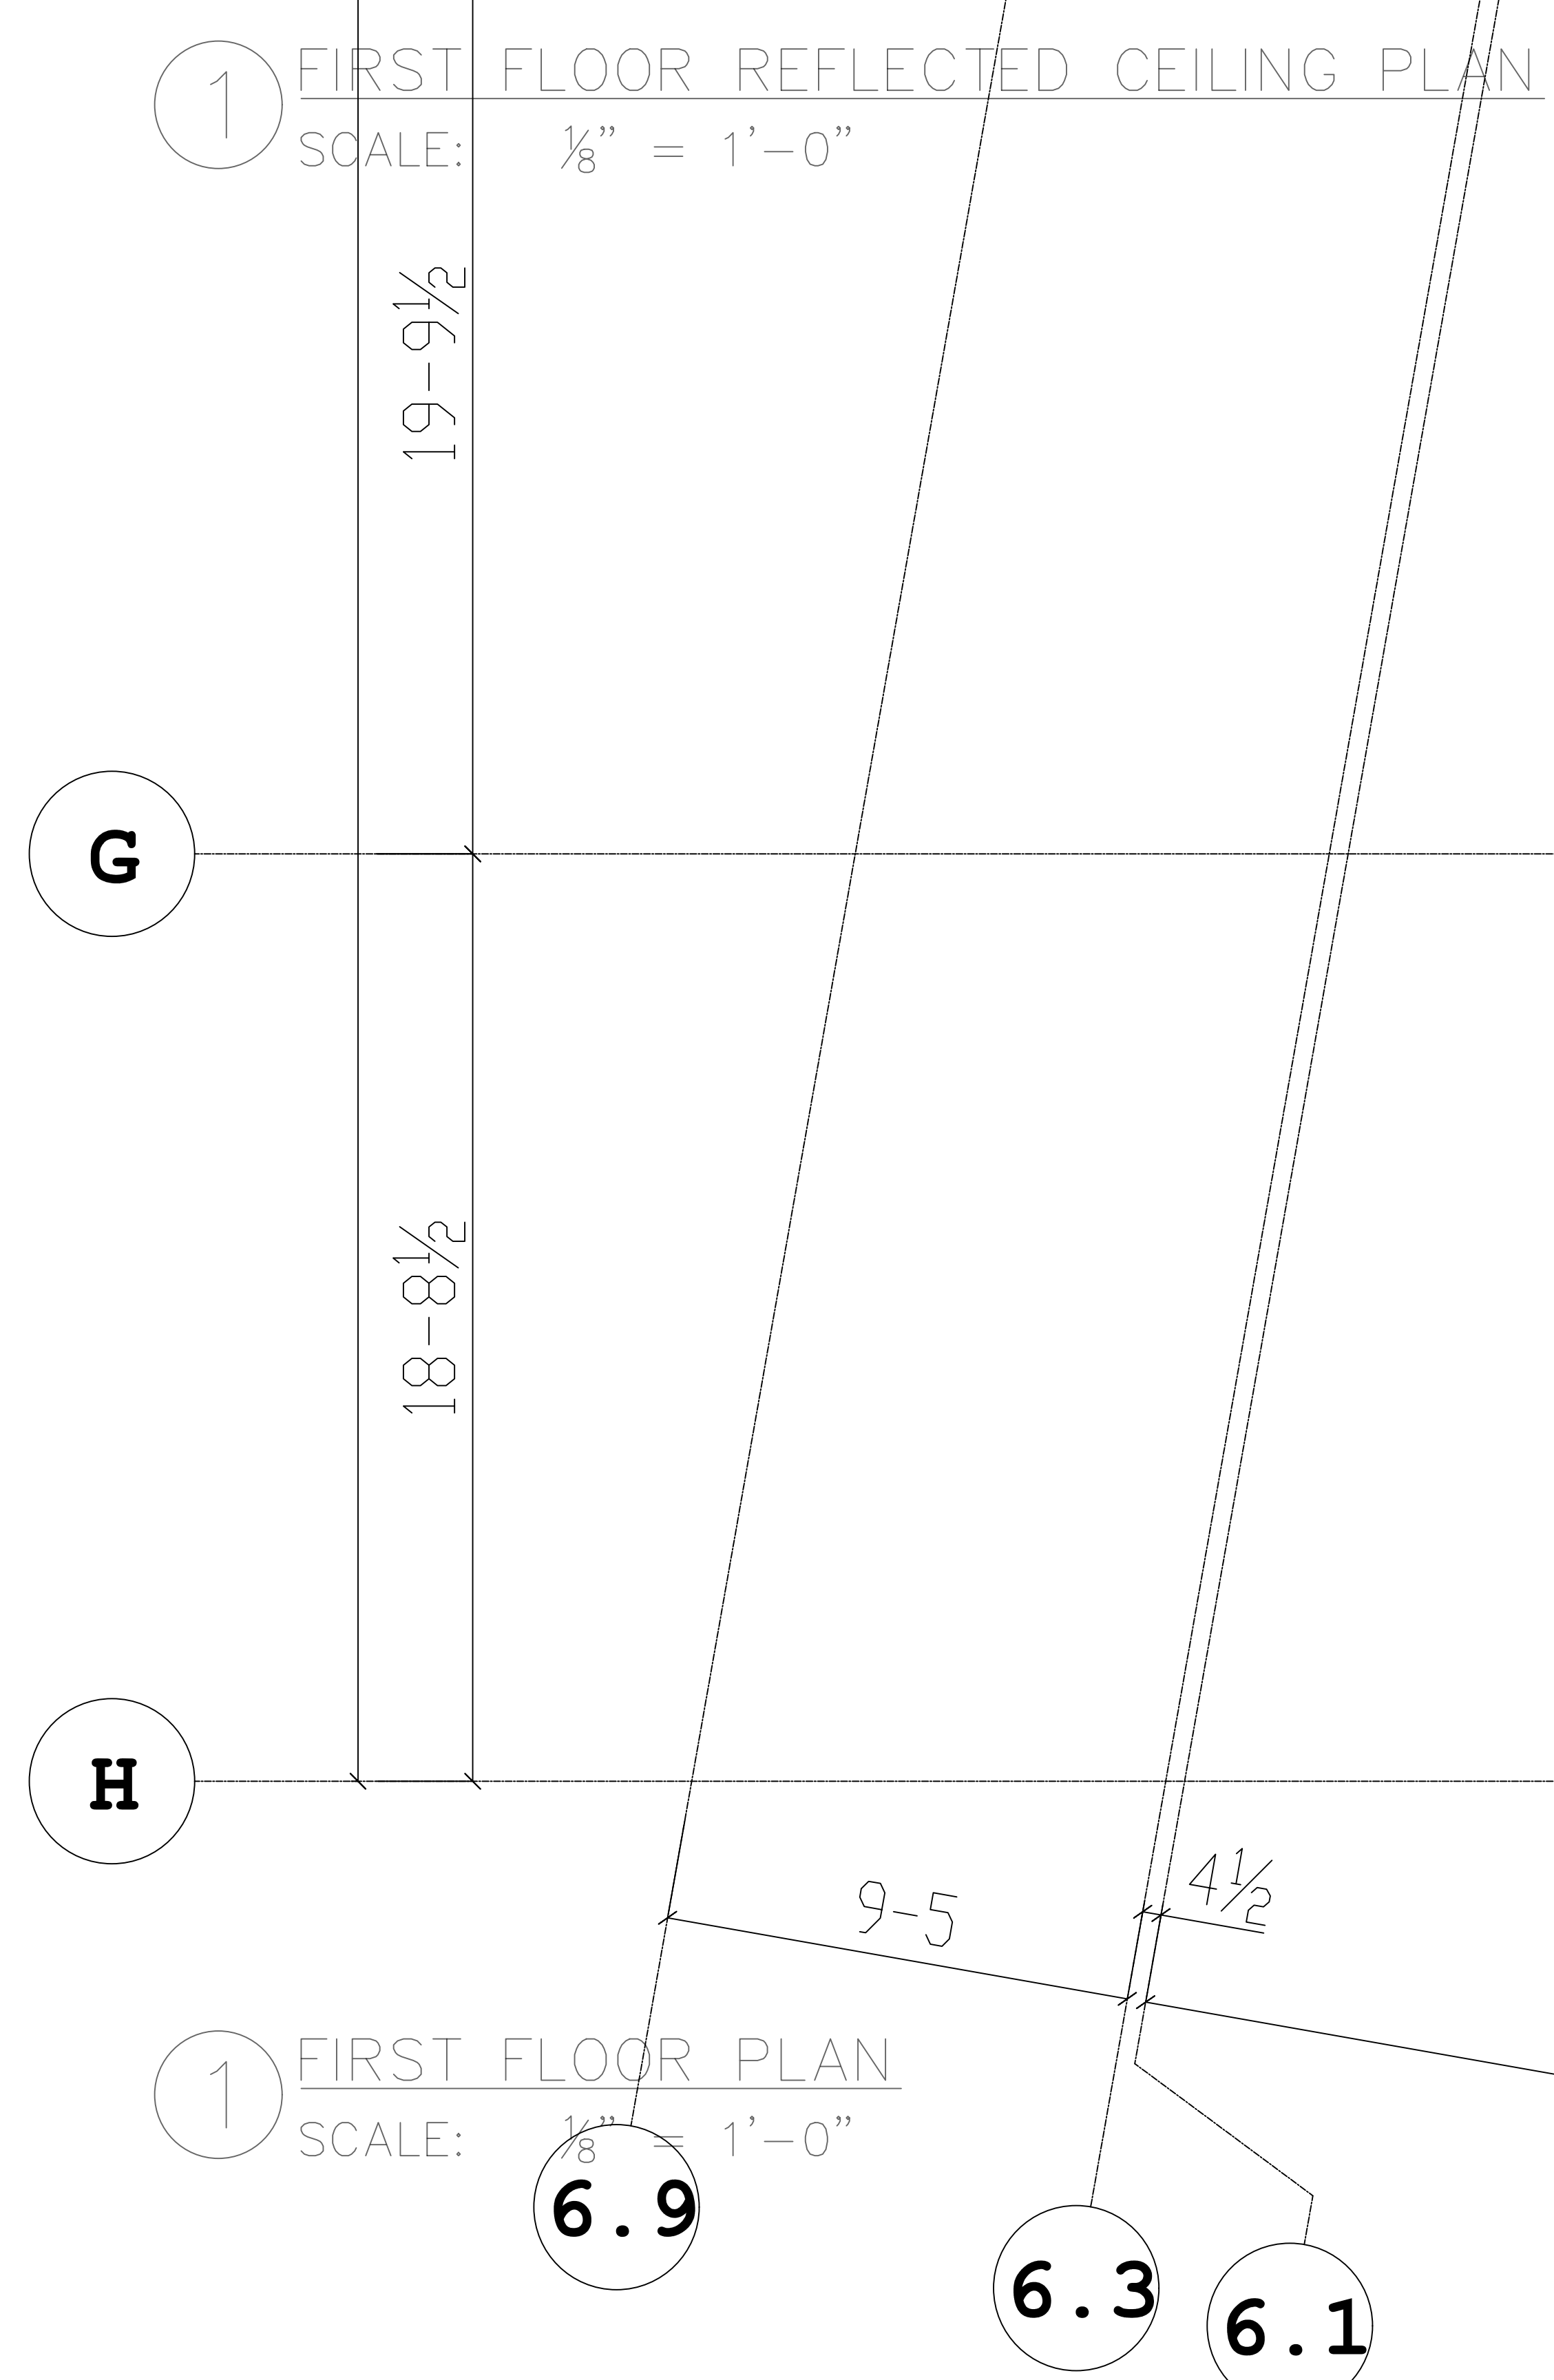

LINE OF AKON INDUSTRIAL WELD ARCHITECT APPROVED EQUAL (D) TRANSPARENT 14MIL WELD VINYL WEIGHT BOTTOMS & ROD MOUNT LENGTH BETWEEN THE WOOD & COLUMN & CONTINUING TO WEST OF FIRE RATED ASSEMBLY, FIRE PENETRATIONS

GYPSUM BOARD CEILING @ FOLDING DOOR

EXISTING OVERHEAD DOOR
NEW FIRE SHUTTER

EXIST. ENTRY
TO BE REPLACED

ENTRANCE 118

86-17/8

AS-BUILT	AS-BUILT
FIELD 1/25/18	FIELD PRINT 2
FIELD 1/25/18	FIELD PRINT 1
REV 10/4/18	ORIGINAL
MARK 1	DATE
DESCRIPTION	

PROJECT NO:	---
CAD DWG FILE:	20181114 18000 2018 107 R.DWG
DRAWN BY:	GD
CHKD BY:	
SCALE:	3/8" = 1'-0"
SHEET TITLE:	

1ST FLR REFRIG. AS-BUILT