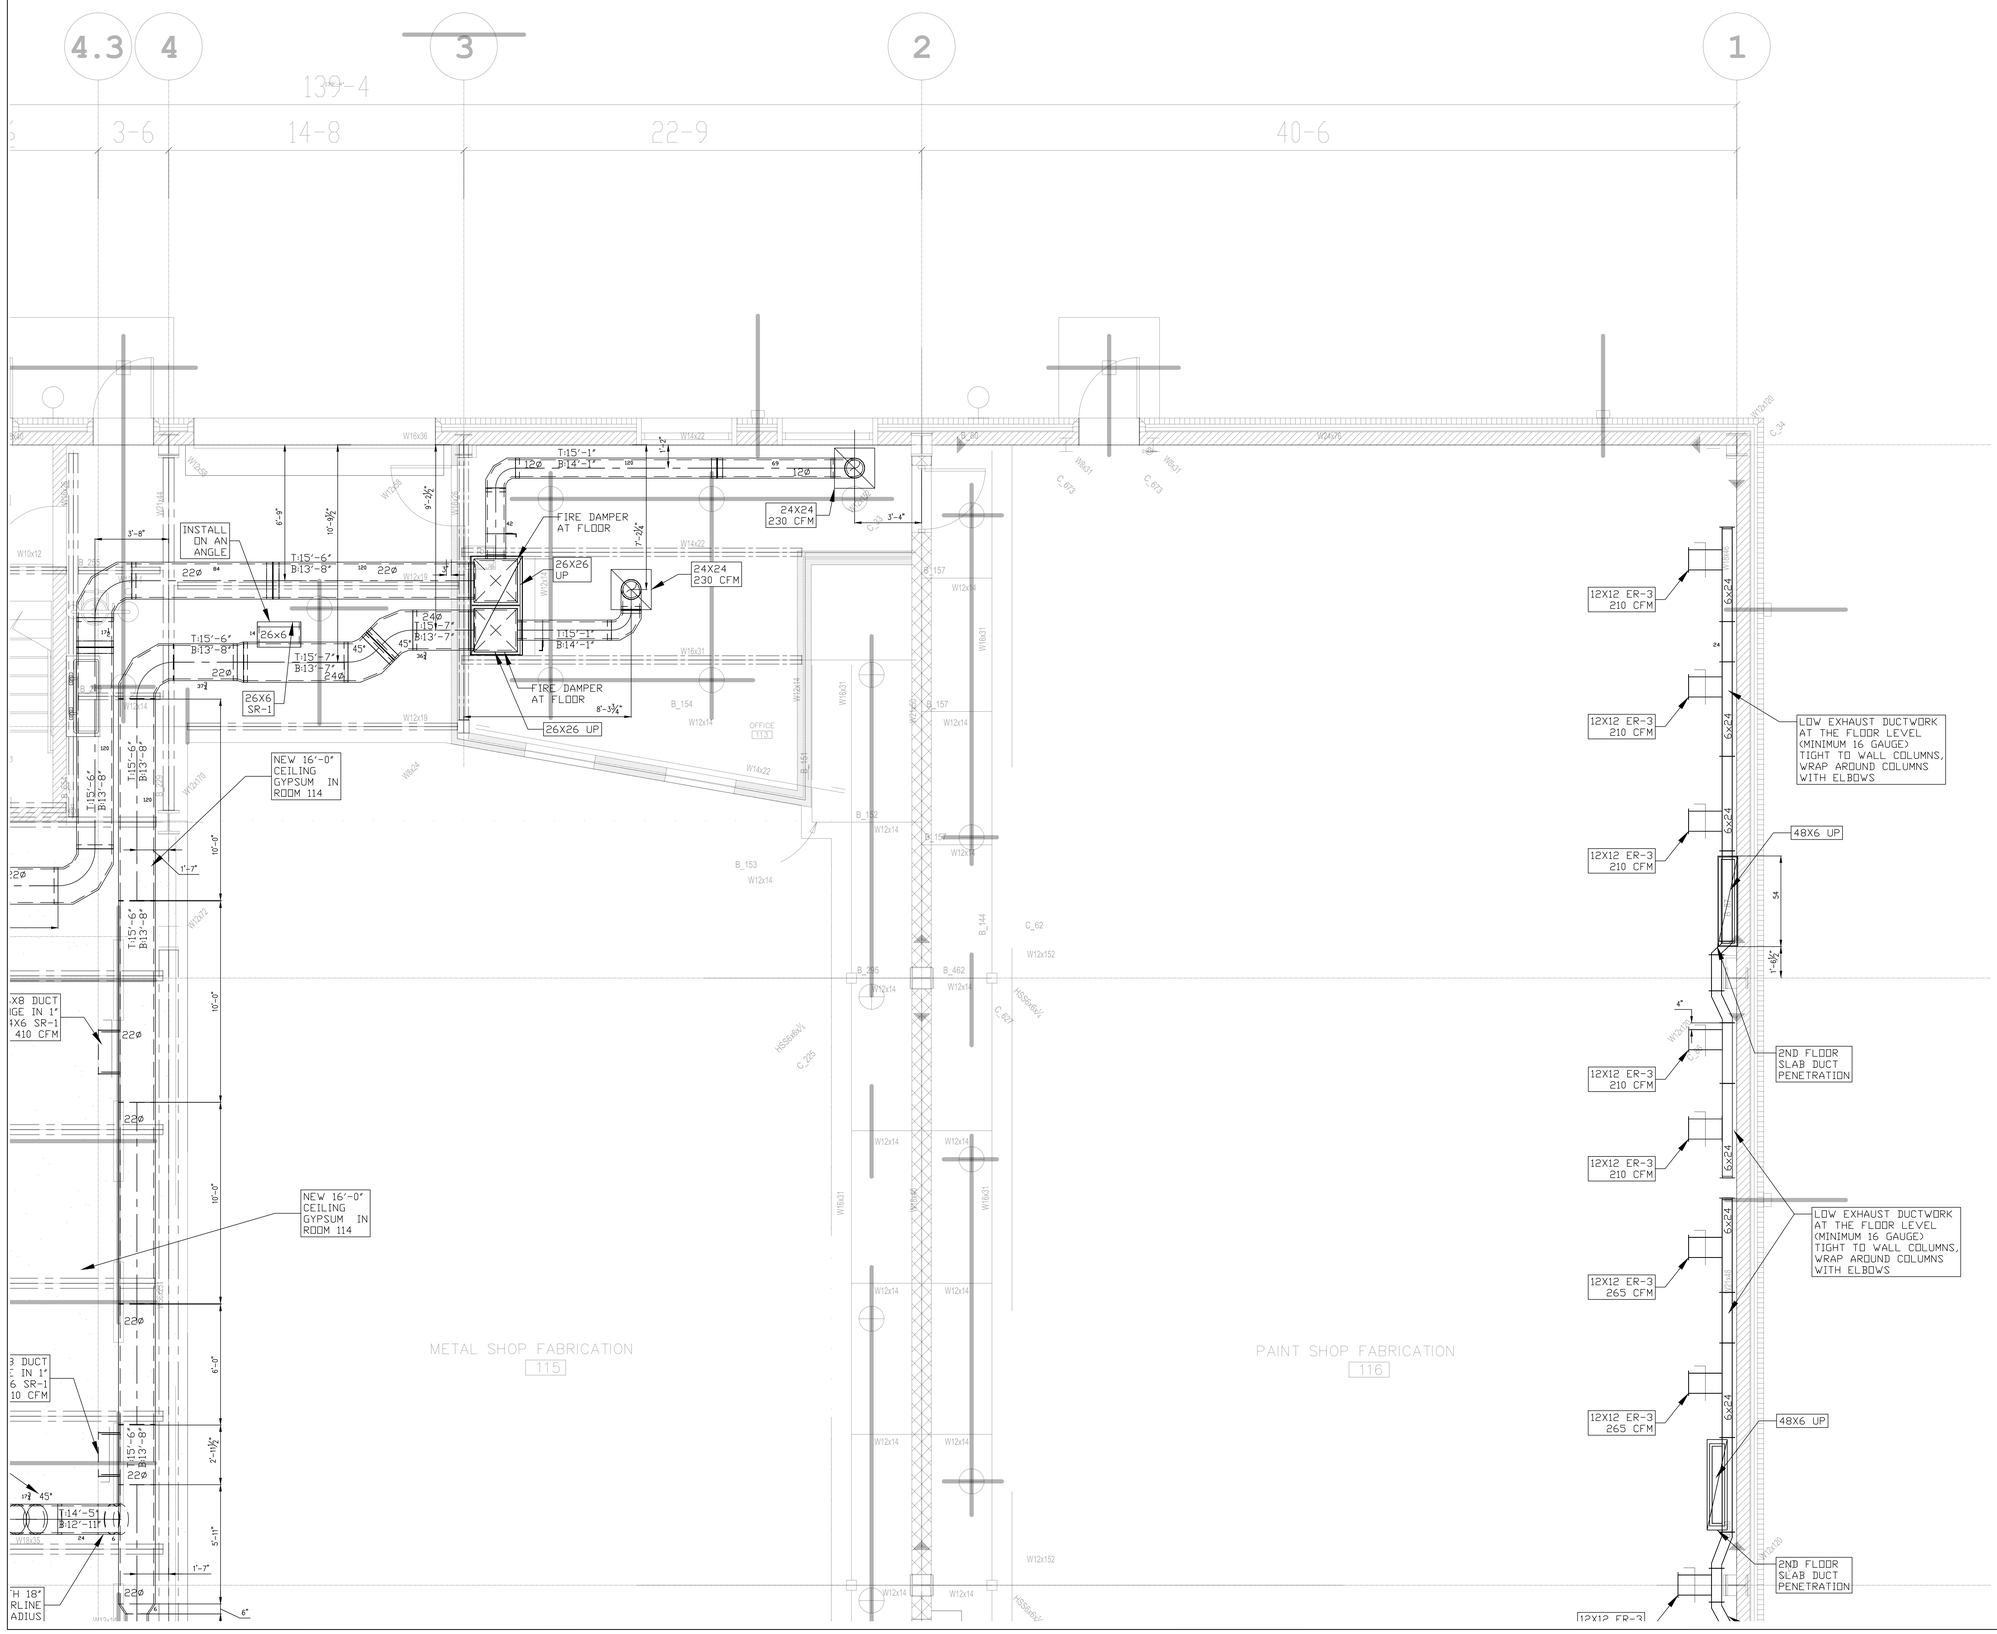

AS BUILT
11-5-2019

No.	REVISION	DATE
⚠	AS BUILT	11/5/19

RICHARD SHEET METAL, INC.

COMMERCIAL & INDUSTRIAL CONTRACTOR
93 HARRISON STREET
PATERSON, NJ 07501
PHONE# (862) 239-1820 FAX# (862) 239-1821

JOB: TWO RIVER THEATER COMPANY
NEW BUILDING

LOCATION: 21 BRIDGE AVE, RED BANK, NEW JERSEY

TITLE: 1ST FLOOR DUCT LAYOUT
HVAC PLAN

DRAWN BY: (SM 20190304)	CHARLES C.	DATE:	9/25/18
SCALE:	3/8" = 1'-0"	MECH. DWG:	M2.0
PROJECT:		DWG No:	RSM-1224-102
CH'D BY:	RL		